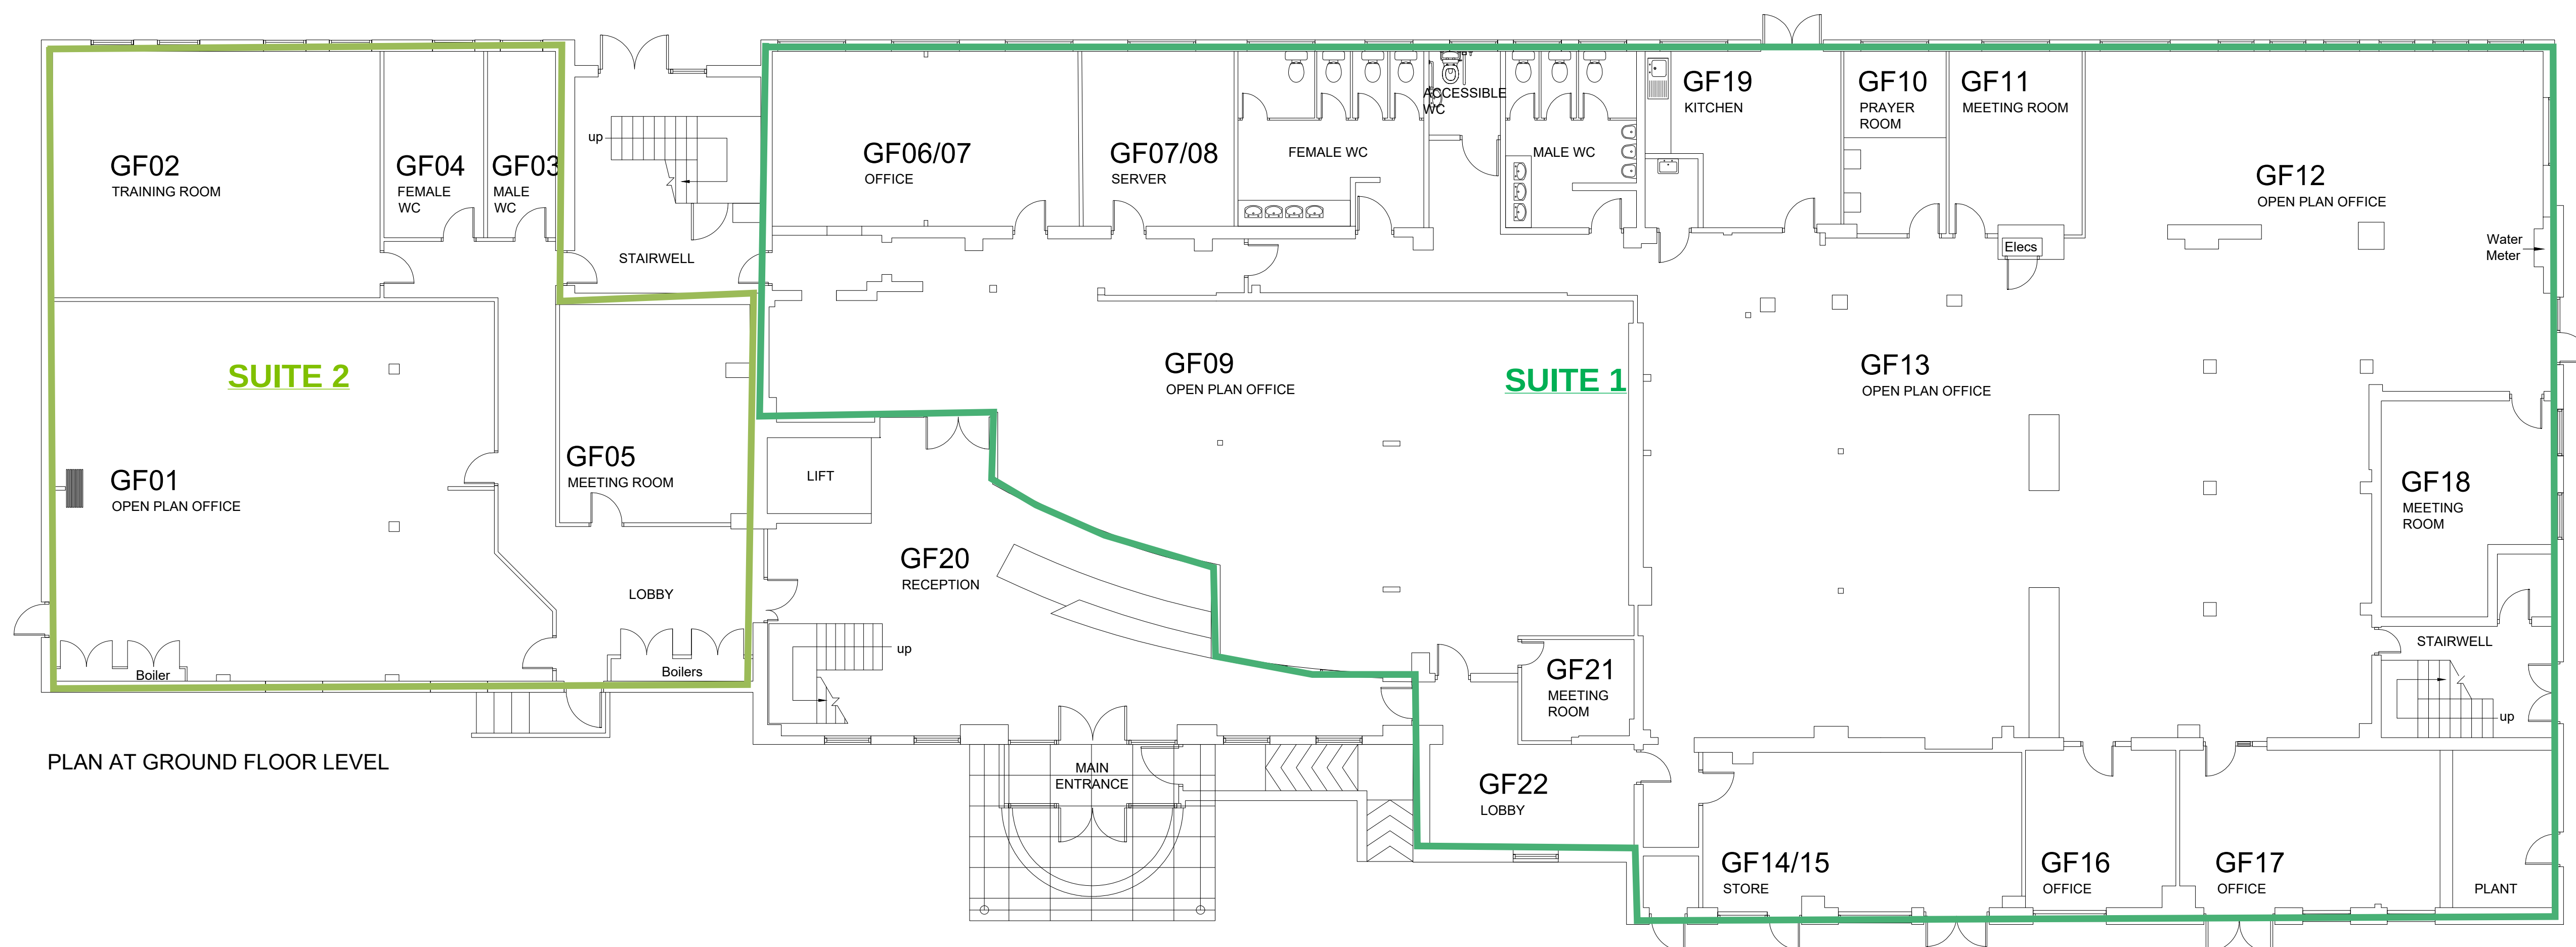
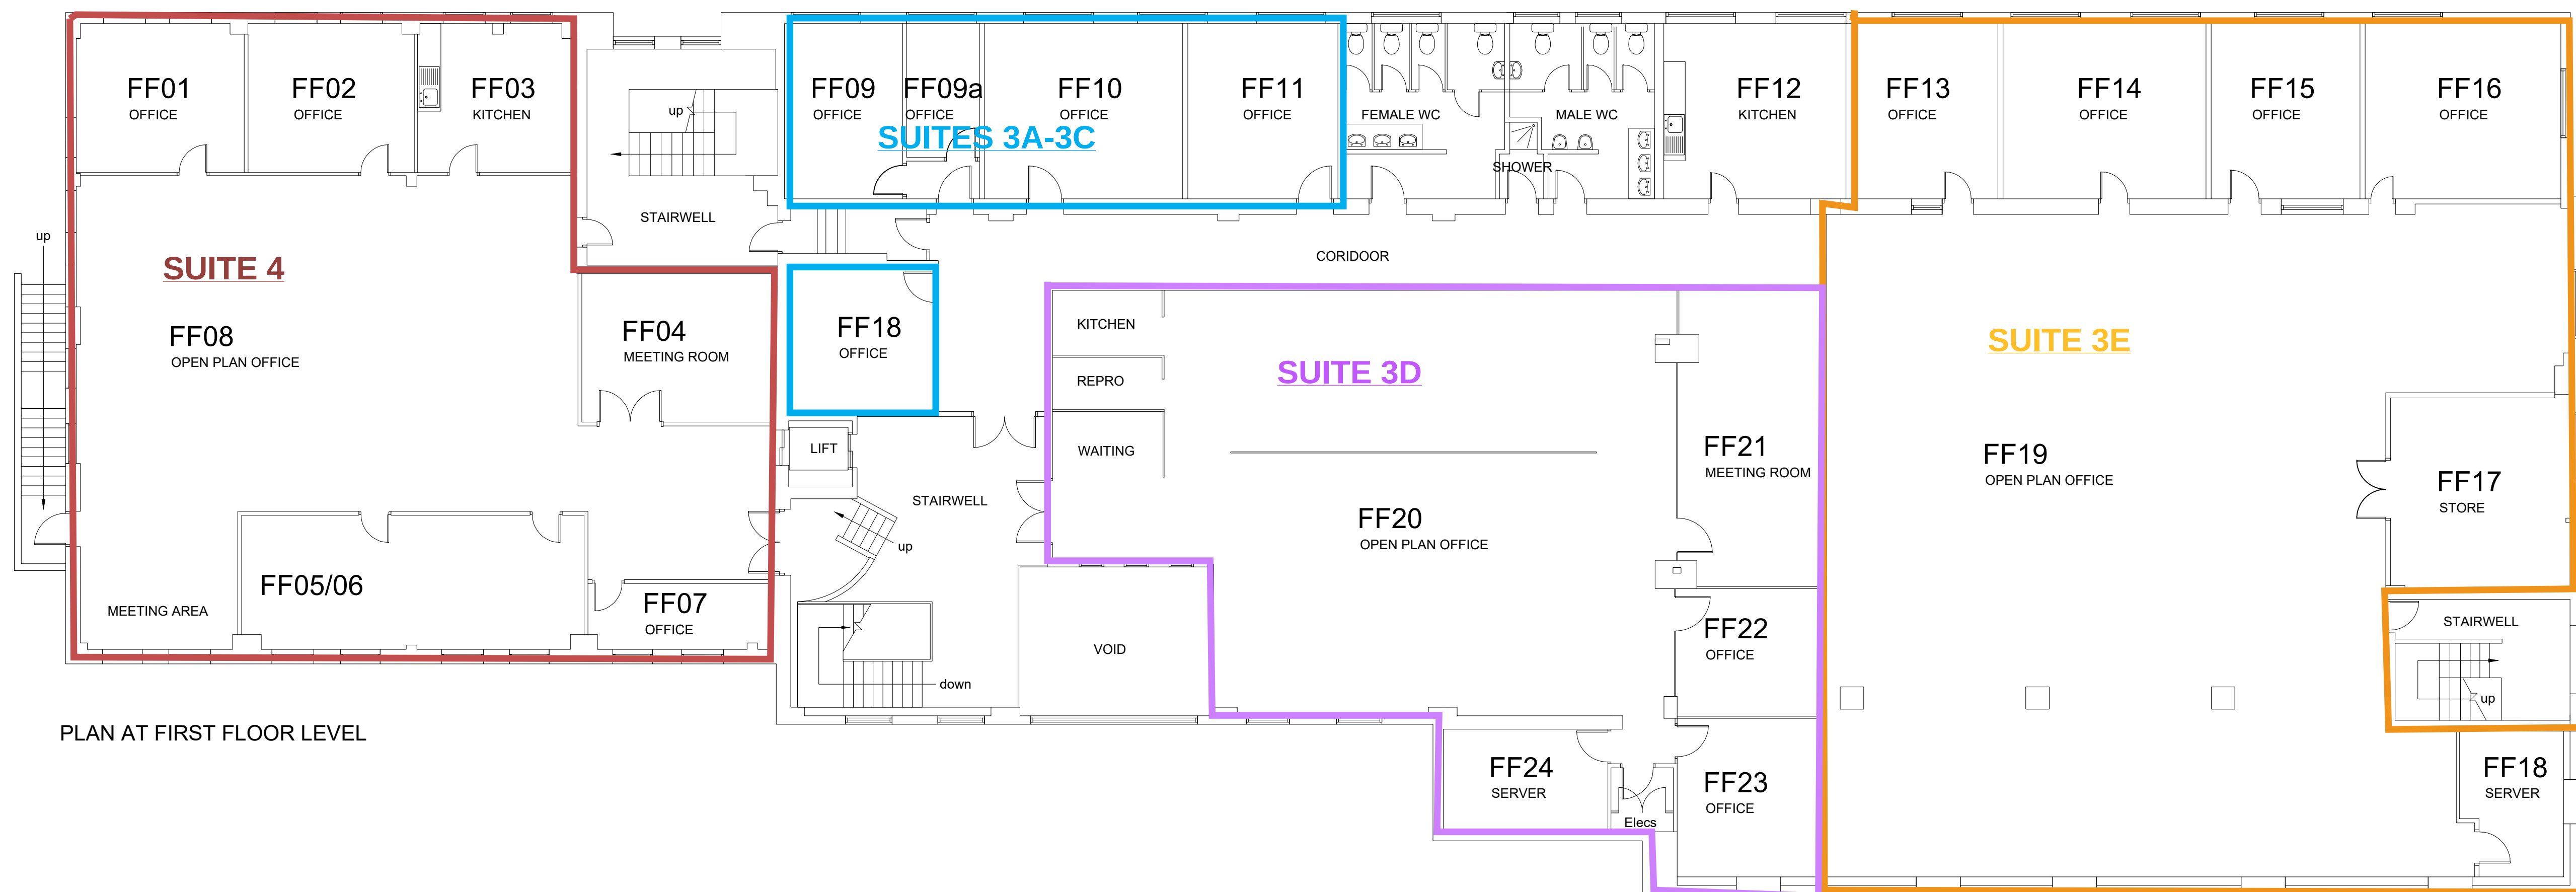


B	As Built tenant fit out mods	PS	21.01.20
A	As Built Status	PS	14.01.20
No	Description	By	Date
TAYLOR - ESTATES - Oakwood House, Taylor Business Park, Warrington, Cheshire. WA3 6WP. T : 0330 383 1000 E : contact@TaylorEstates.com			
Project Ribble House, Meanygate, Bamber Bridge, Preston, Lancashire PR5 6UR			
Title Floor Plan Ground and First Floor Levels AS BUILT			
Survey By -- Date --			
Drawn By PS Date 13.01.20			
Scale 1:100 As drawn at A1			
Philpro Dwg. No. C1141-001 B			
Client's Dwg. No. --			